

- General Notes
1. All DIMENSIONS in millimeters. Do not scale from drawing.
Use figured dimensions only.
 2. ALL dimensions to be checked on site prior to commencement of works
 3. ALL FILLERS variable to suit site conditions.

REVISION TABLE

Client: JJ Rhatigan

PROJECT:

BLACKHORSE LANE

DRAWING TITLE:

KITCHEN (UNIT D1a)
Plan-Elevation-Visual

SCALE: NTS

DRAWN BY:

AnnaMcWilliams

DATE:

19.12.2025

APPROVED BY:

DATE:

DWG No:

BHL_WDL_XX_ZZ_DR_X_730026

DRAWING STATUS:

AB - As Built

REV:


AB



Kitchen Visual

AS BUILT

Order	Description	Width
1	Base Filler	30
2	Sink Base cabinet 1 door LH	600
3	Integrated dishwasher	450
4	Base cabinet built under Combi Oven Housing	600
5	Base cabinet 2 Pan drawers 1 drawer	450
6	Tall Fridge Freezer Housing Unit RH	600
7	Wall filler	30
8	Wall cabinet 1 door LH	600
9	Wall cabinet 1 door RH	450
10	Extractor Wall cabinet 1 door LH	600
11	Wall cabinet 1 door RH	450

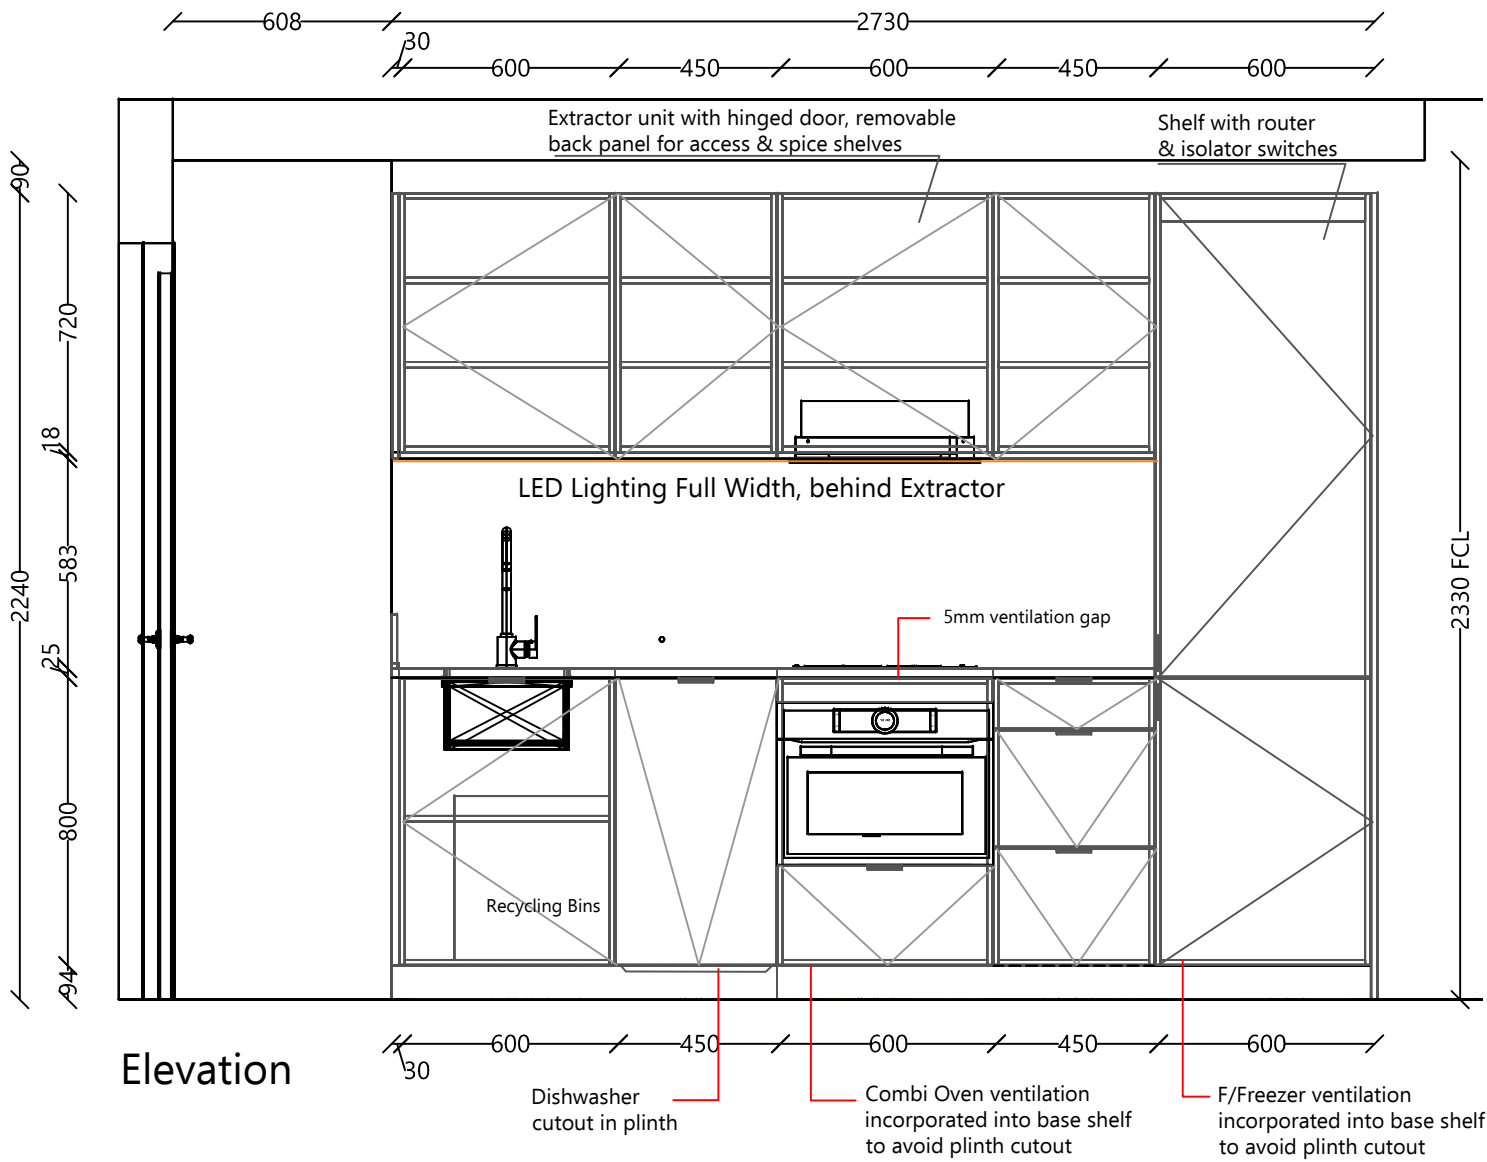

Elevation

